








PROJECT PLANS USED :	
SHEETS	DATE
ARCHITECTURAL DRAWINGS	
A0.0 THRU A9.2	09/30/15
STRUCTURAL DRAWINGS	
S-1.1 THRU S-3.2	08/13/15
MECHANICAL DRAWINGS	
M0.1 THRU M6.3	08/13/15

DATE:	REVISIONS
10/14/15	
1 - 12/07/15	PER REVISION AND RESUBMIT
2 - 12/22/15	PER TRUSS MARKUPS
3 - 1/25/16	PER STORAGE RFI
4 - 3/07/16	PER REVISED ANNEX DWGS

**CALIFORNIA DEPARTMENT OF TRANSPORTATION**  
 2885 SOUTH HIGUERA  
 SAN LUIS OBISPO, CALIFORNIA

ENGINEER  
 ASHLEY & VANCE ENGINEERING, INC.  
 805-547-9200  
 ARCHITECT  
 ARRIS STUDIO ARCHITECTS  
 805-547-2940  
 CUSTOMER  
 B/H CONSTRUCTION  
 805-462-3350


**G2 NATIONAL**  
 Evolution in Wood-Framed Structure.  
 G2 NATIONAL LLC  
 2185 GREEN VISTA DRIVE # 212 SPARKS, NEVADA 89431.

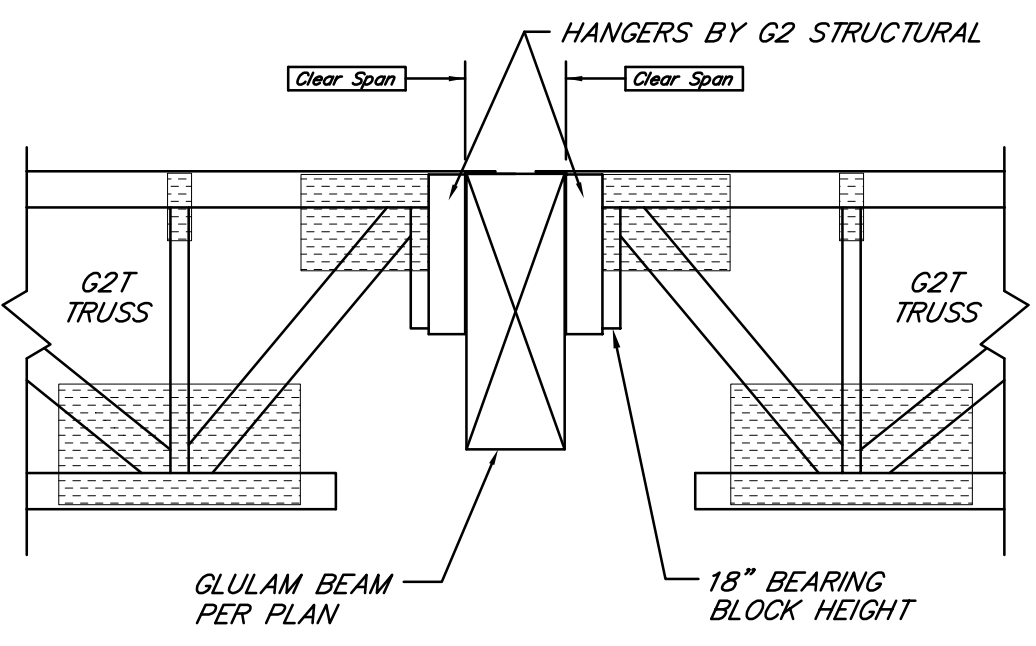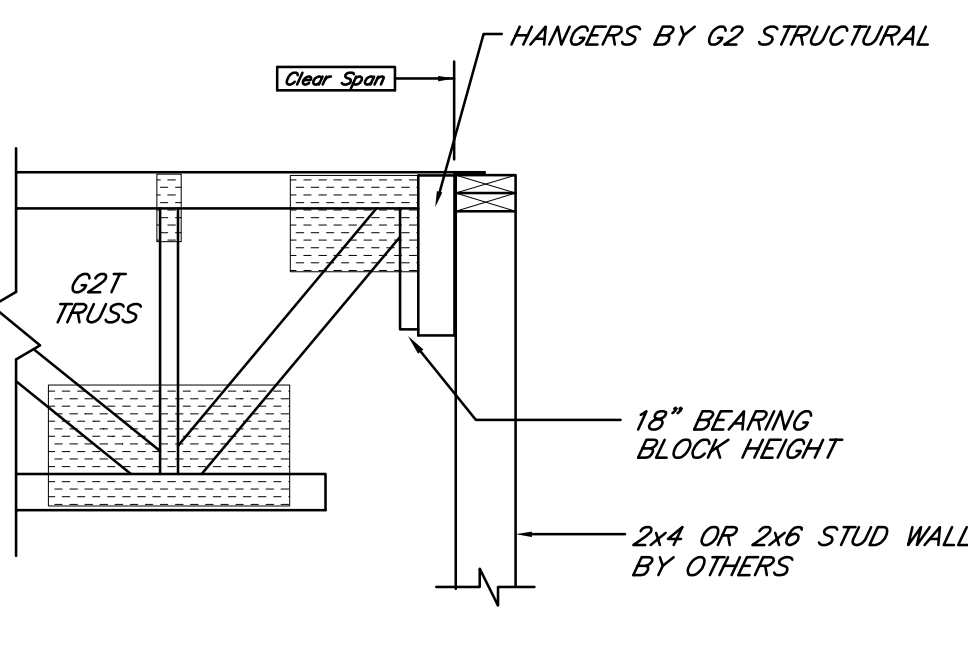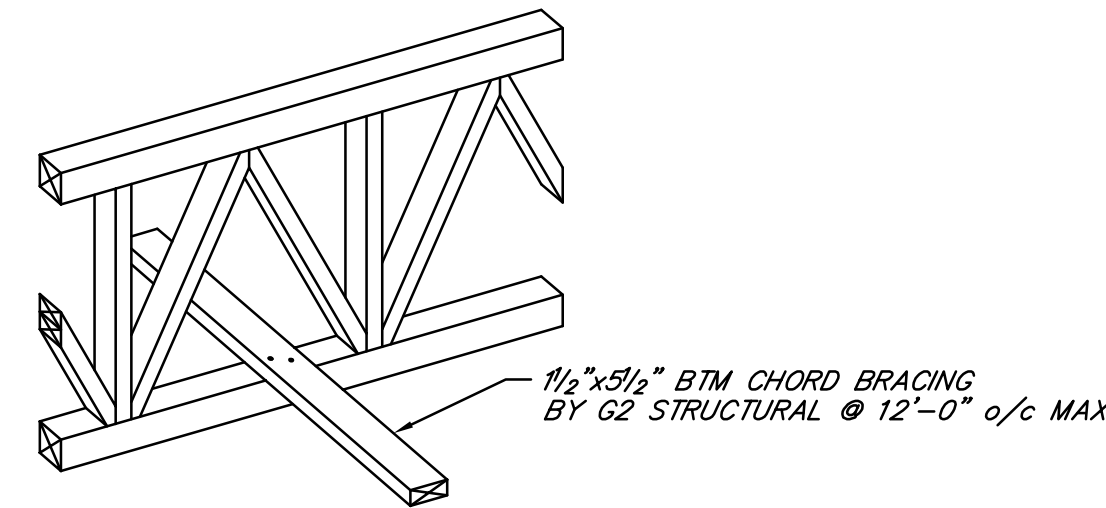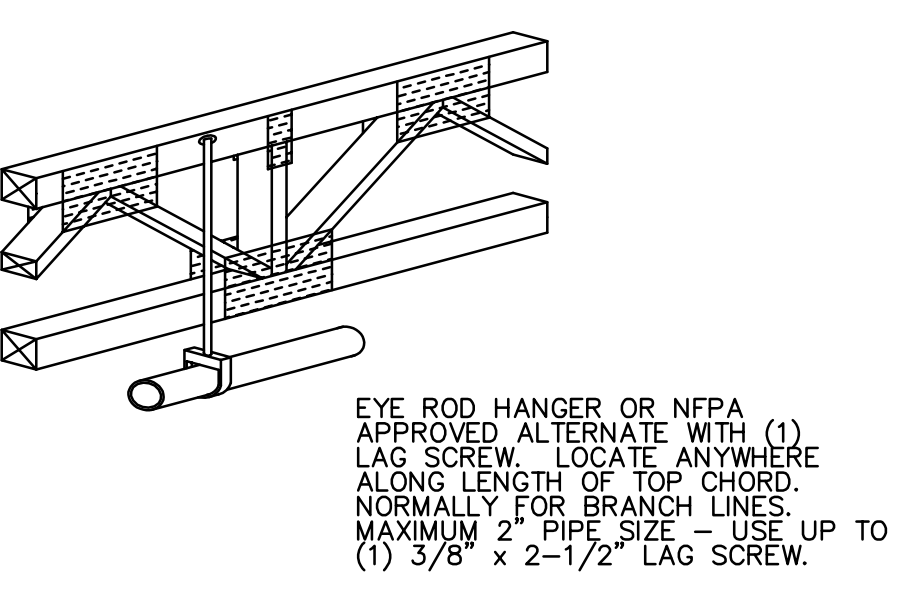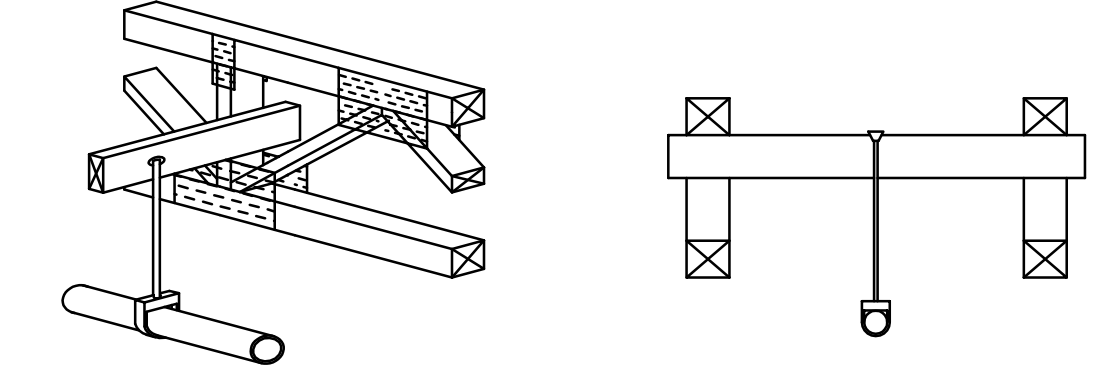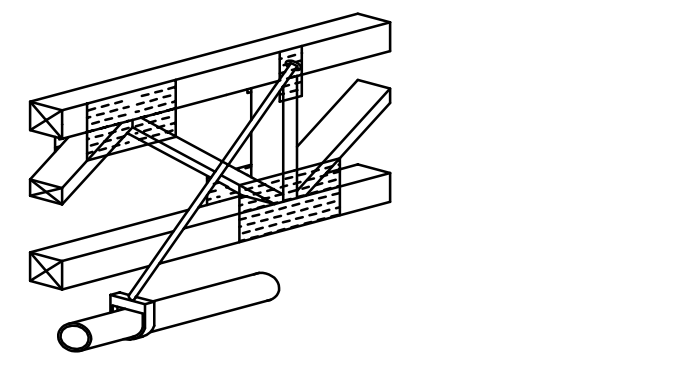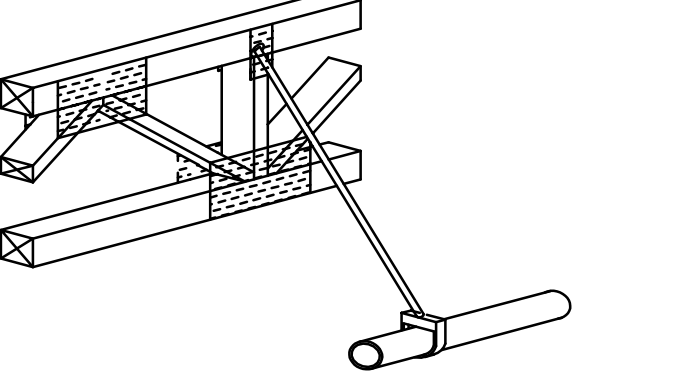		2	G2T IN HANGER TO WOOD BEAM REFER TO PROJECT PLAN DETAILS FOR MORE INFO NOT TO SCALE 	1	G2T IN HANGER TO STUD WALL REFER TO PROJECT PLAN DETAILS FOR MORE INFO NOT TO SCALE 
C	BOTTOM CHORD BRACING	B	2-1/2" THROUGH 4" DIA. SPRINKLER LINE 	A	2" DIA. & SMALLER SPRINKLER LINE 
F	TRAPEZED SPRINKLER LINE 	E	LONGITUDINAL SWAY BRACE 	D	LATERAL SWAY BRACE 


**WARNING:**  
 Drilling, sawing, sanding or machining wood products generates wood dust and other substances known to the State of California to cause cancer. Avoid inhaling dust generated from wood products or use a dust mask or other safeguards for personal protection.  
 Wood products emit chemicals known to the State of California to cause birth defects or other reproductive harm.

**FIRE SPRINKLER ATTACHMENT NOTES:**


- WOOD SCREWS WITH A MAXIMUM DIAMETER OF 1/4" MAY BE USED ANYWHERE ON THE TOP FLANGE OF THE I-JOISTS, UNLESS NOTED OTHERWISE ON PLANS.
- DO NOT DRILL HOLES, DRIVE HEAVY SCREWS, OR USE LAG BOLTS IN THE BOTTOM FLANGE OF I-JOISTS, EXCEPT AS NOTED BELOW. LAGS & SCREWS TO BE INSTALLED BY TURNING WITH A TOOL, NOT DRIVING WITH A HAMMER.
- COORDINATE ATTACHMENT OF SPRINKLER PIPE GREATER THAN 2" DIAMETER AND LARGER WITH I-JOIST LAYOUT AND CALCULATIONS. MFR HAS ASSUMED THAT THE ENGINEER OF RECORD HAS ALLOWED PSF FOR BRANCH SPRINKLER LINES 2" DIAMETER AND LESS.
- PREDRILL HOLES GREATER THAN 1/4" DIAMETER INTO FLANGES.

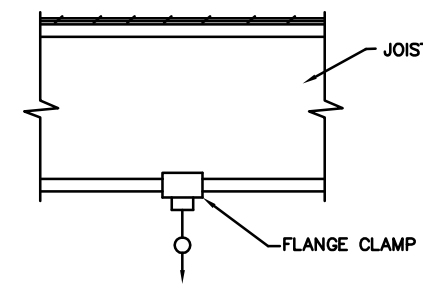


**A** FLANGE CLAMP CONNECTED TO I-JOIST BOTTOM CHORD

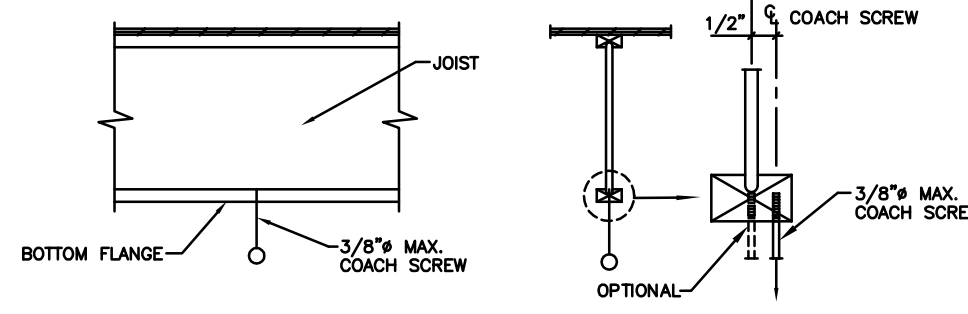


**B** COACH SCREW CONNECTED TO I-JOIST BOTTOM CHORD

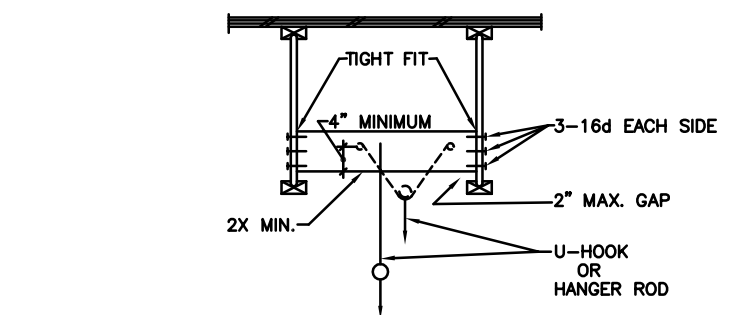


**C** ROD CONNECTED TO 2x TRAPEZED BETWEEN I-JOIST

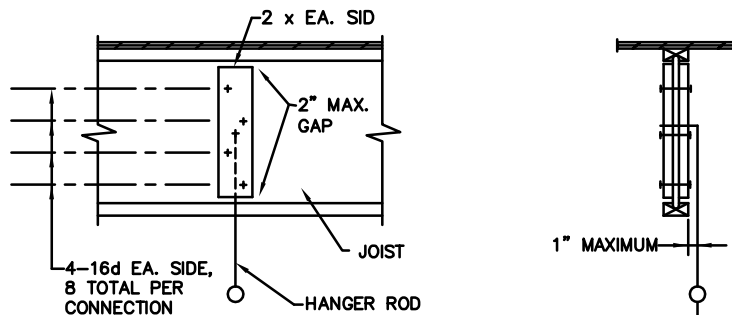

**D** ROD CONNECTED TO I-JOIST WEB FILLER

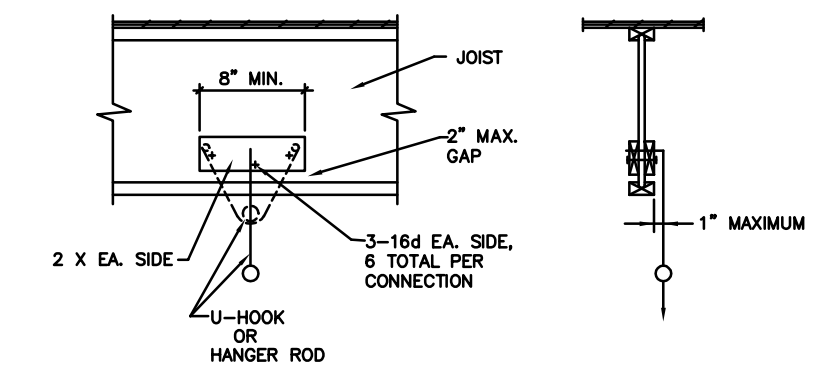

**E** U-HOOK & F.S. ROD CONNECTED TO I-JOIST WEB FILLER

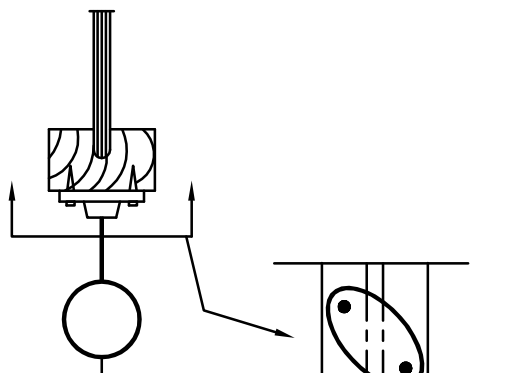


**F** FLANGE CONNECTED TO I-JOIST BOTTOM CHORD

**ATTACHMENT DETAILS**

SPRINKLERS AND SPRINKLER ATTACHMENT, INCLUDING WOOD SUPPORTS, ARE FURNISHED AND INSTALLED BY OTHERS.


6

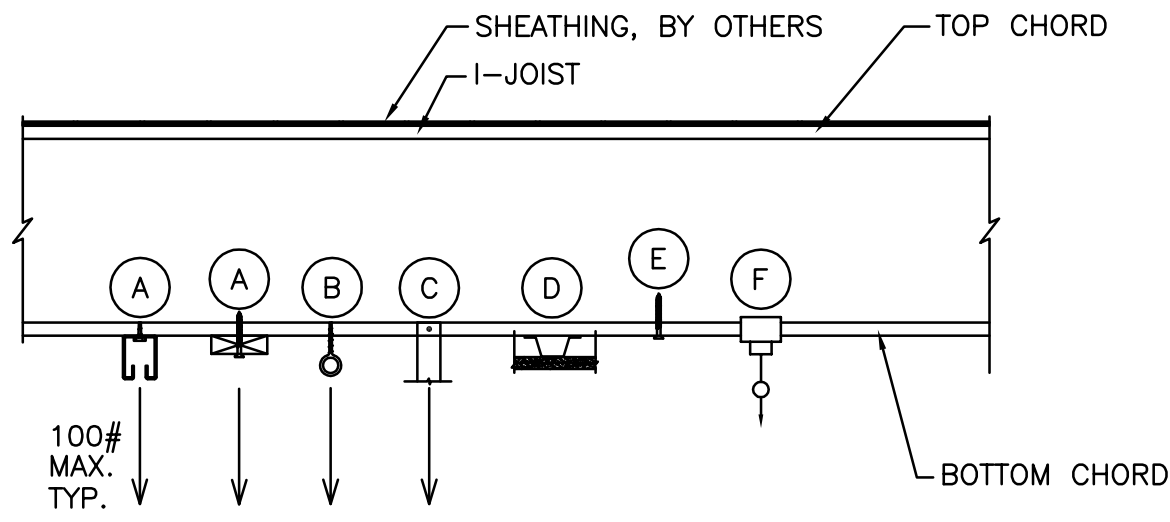


ANY CONNECTION REQUIRING A SCREW GREATER THAN 1/4"Ø MUST BE DETAILED AND SUBMITTED TO MFR FOR APPROVAL

**TYPICAL DETAIL NOTES:**


- PRE-DRILL FOR ALL SCREWS GREATER THAN 1/4"Ø
- POINT LOADS GREATER THAN 100# REQUIRE A DETAIL, PREPARED BY OTHERS AND SUBMITTED FOR APPROVAL.
- 1/4"Ø SCREWS OR LESS ARE ALLOWED IN THE SIDE OF EITHER THE TOP OR BOTTOM CHORD.

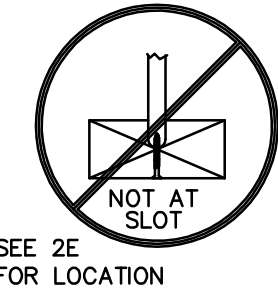


**CONDITION A**  
UNISTRUT, 2x, OR SIMILAR WITH 3/8"Ø MAXIMUM LAG SCREW

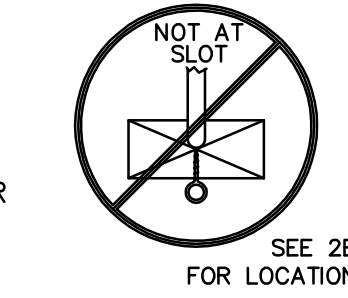


**CONDITION B**  
3/8"Ø MAXIMUM COACH SCREW OR SUSPENDED CEILING EYE BOLT

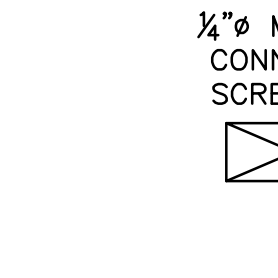

**CONDITION C**  
1/4"Ø MAXIMUM SCREW OR 2-10d MAXIMUM NAILS PER CONNECTION (2 CONNECTIONS PER TRUSS), OR #10 SCREW INTO SIDE FACE OF TOP OR BOTTOM CHORD

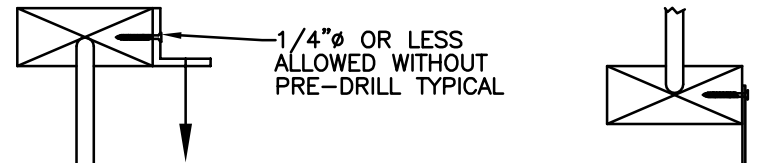

**CONDITION D**  
DIRECT APPLIED RESILIENT CHANNEL AND/OR GYPSUM BOARD CEILING, USE #10 SCREWS MAXIMUM, NO RESTRICTIONS



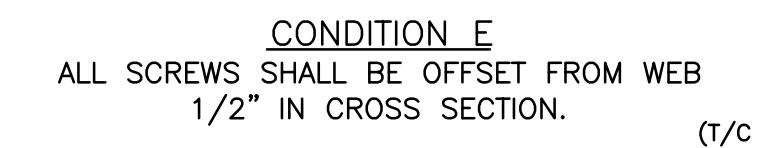


**CONDITION E**  
ALL SCREWS SHALL BE OFFSET FROM WEB 1/2" IN CROSS SECTION.



**CONDITION F**  
FLANGE CLAMP - NO EXCEPTIONS

**TOP AND BOTTOM CHORD ATTACHMENT DETAILS PLUMBING/ELECTRICAL/CEILING**

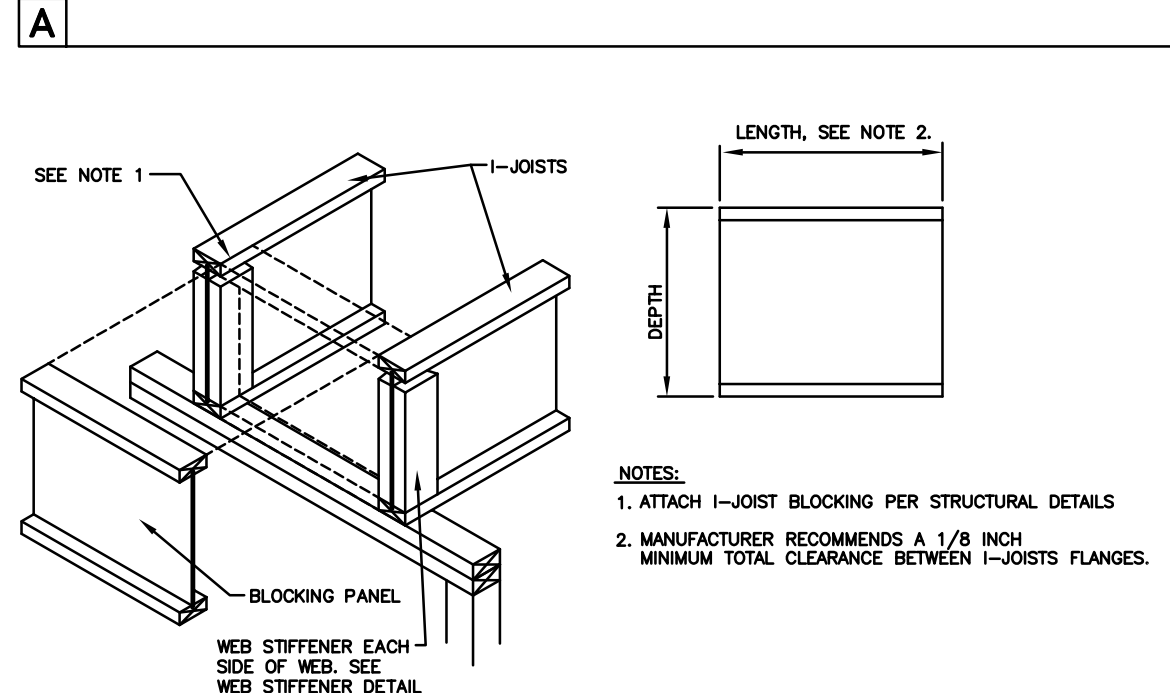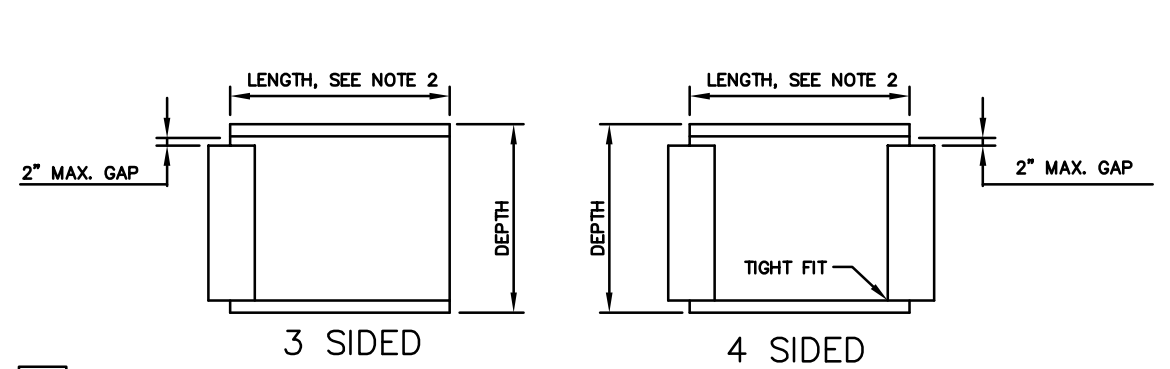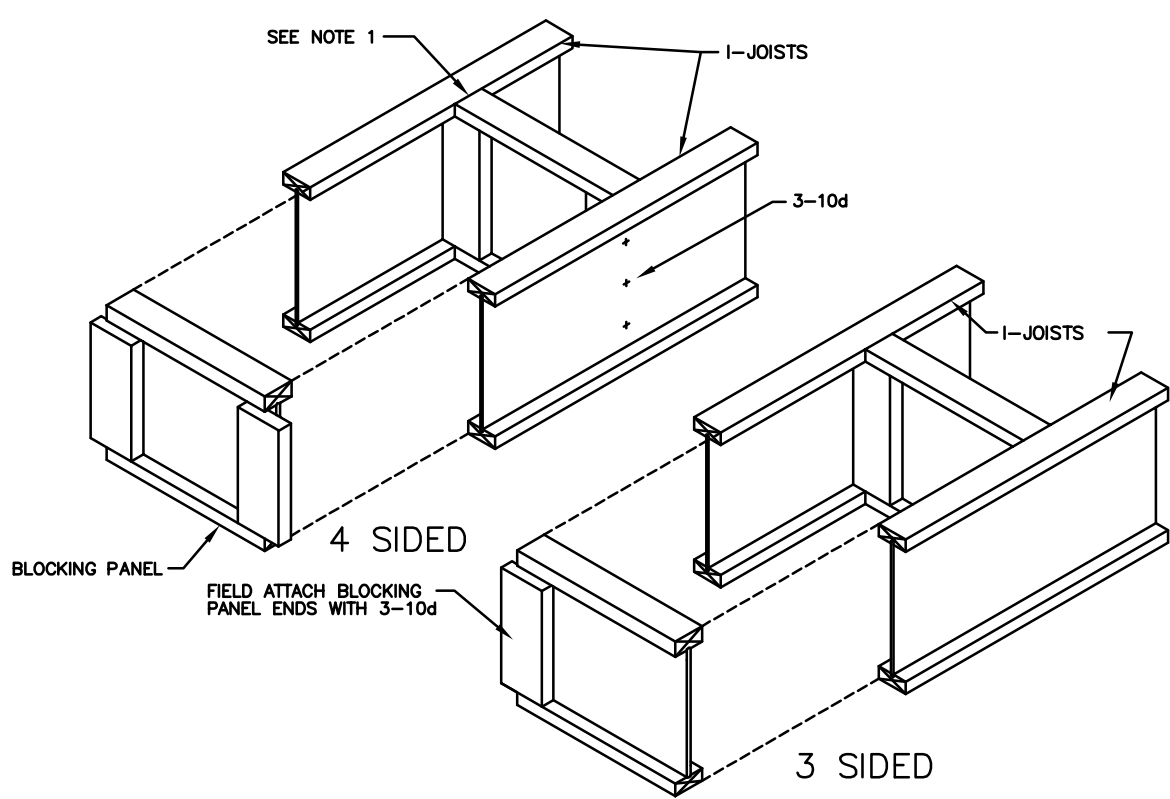


**A** BLOCKING PANEL INSTALLATION

**B** MULTI-JOIST ASSEMBLY

5

**DO NOT CUT TOP AND BOTTOM FLANGES**

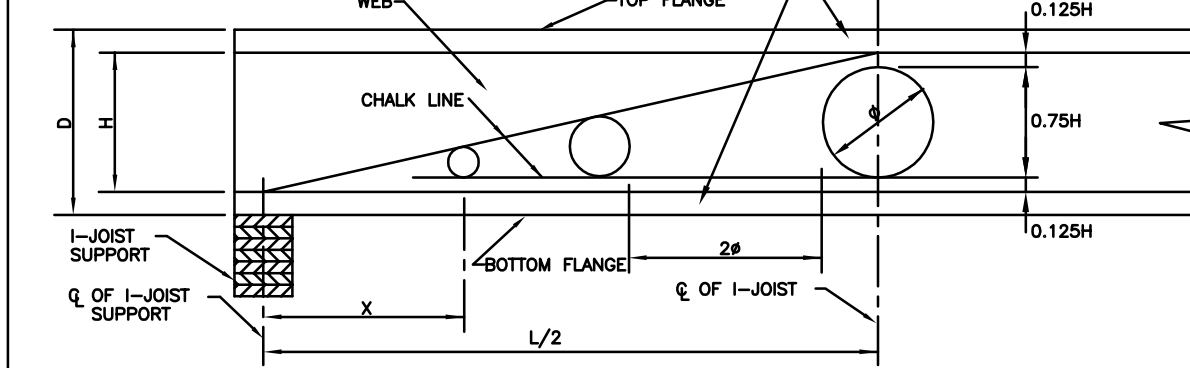

**WHERE:**  
 X = DISTANCE, IN FEET, FROM CENTERLINE OF SUPPORT TO CENTERLINE OF HOLE  
 L = JOIST SPAN, IN FEET, CENTERLINE OF SUPPORT TO CENTERLINE OF SUPPORT  
 Ø = HOLE DIAMETER, IN INCHES  
 H = WEB DEPTH, IN INCHES

FOR SIMPLE SPANS AND UNIFORM LOADS, A CHALK LINE CAN BE USED TO SHOW ALLOWABLE HOLE SIZES PERMITTED AT A GIVEN LOCATION ALONG THE TOP AND BOTTOM FLANGES. THESE HOLES MAY BE PLACED ANYWHERE IN THE VERTICAL DIRECTION BETWEEN THE TOP AND BOTTOM FLANGES, PROVIDED A 0.125H GAP IS MAINTAINED BETWEEN HOLES AND FLANGES. THESE HOLES MUST EXCEED TWICE THE DIAMETER OF THE LARGEST SQUARE HOLE, AND ESPECIALLY LARGE AND MULTIPLE HOLES, TEND TO INCREASE DEFLECTION.

**FOR SIMPLE SPANS AND UNIFORM LOADS, THE FOLLOWING FORMULA MAY BE USED TO DETERMINE HOLE SPACING REQUIREMENTS:**


$$X = \frac{3L}{5H}$$

$$Ø = \frac{5XH}{3L}$$

**NOTES:**  
 GENERAL - DO NOT CUT THE WEB WITHIN D/2 OF THE SUPPORT CENTERLINE. OTHERWISE A 1 1/4" HOLE Ø 2" CAN BE CUT IN THE WEB ANYWHERE, THE TOP AND BOTTOM FLANGES ARE NEVER TO BE CUT.  
 SQUARE HOLES - THE SIDES OF SQUARE HOLES SHALL NOT EXCEED TWO THIRDS THE MAXIMUM ROUND HOLE DIAMETER.  
 MULTIPLE HOLES - WHERE MORE THAN ONE HOLE IS NECESSARY, THE DISTANCE BETWEEN HOLES MUST EXCEED TWICE THE DIAMETER OF THE LARGEST ROUND HOLE OR TWICE THE SIDE OF THE LARGEST SQUARE HOLE.


**SPECIAL - EXCEPTIONS WILL REQUIRE THAT ADDITIONAL SUBSTANTIATING DATA BE FURNISHED TO THE LOCAL BUILDING DEPARTMENT.**

**HOLE SIZE AND LOCATION DETAIL**

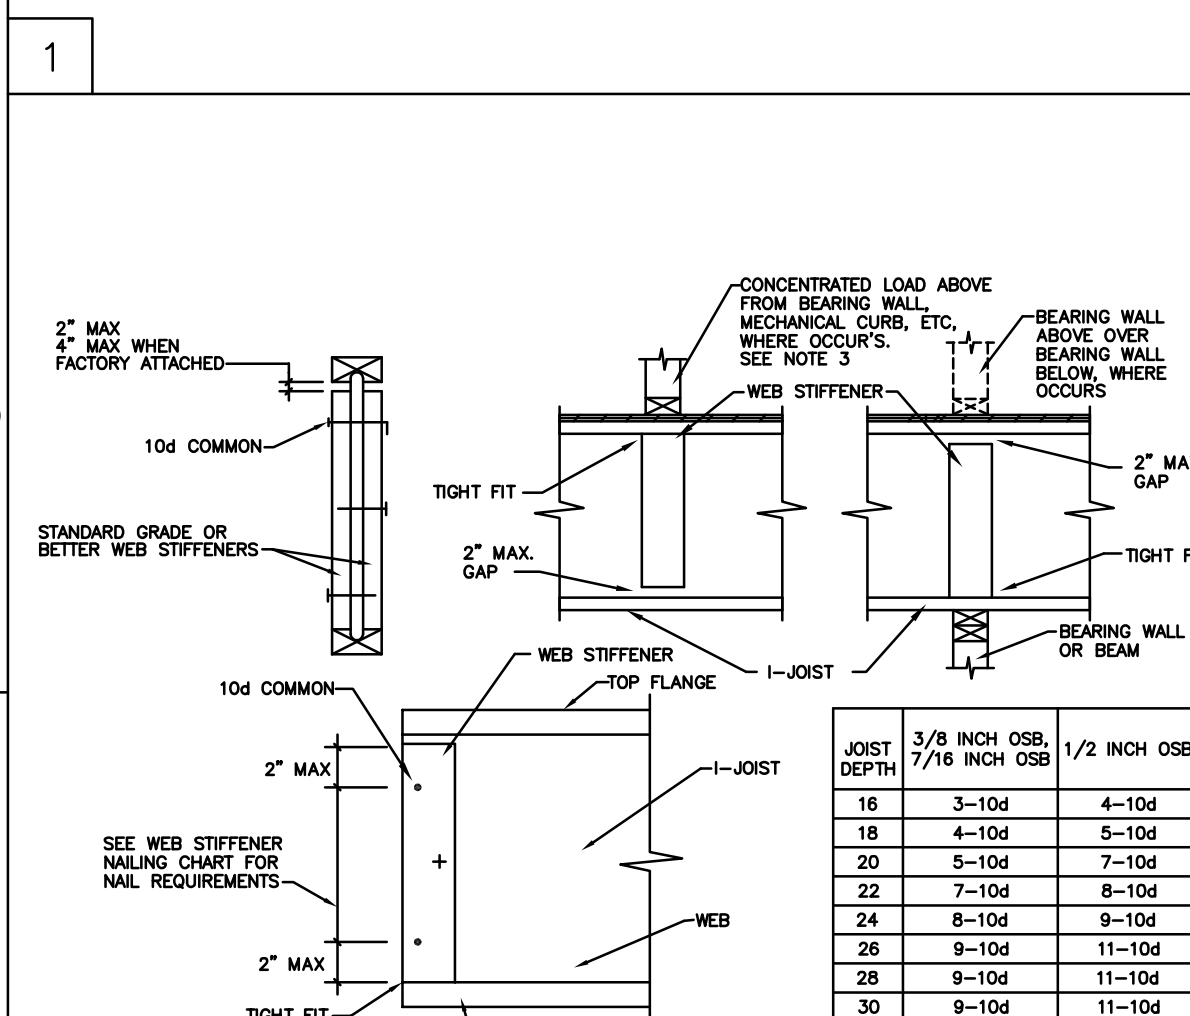

JOIST DEPTH	3/8 INCH OSB, 7/16 INCH OSB	1/2 INCH OSB
16	3-10d	4-10d
18	4-10d	5-10d
20	5-10d	7-10d
22	7-10d	8-10d
24	8-10d	9-10d
26	9-10d	11-10d
28	9-10d	11-10d
30	9-10d	11-10d

**WEB STIFFENER ATTACHMENT**

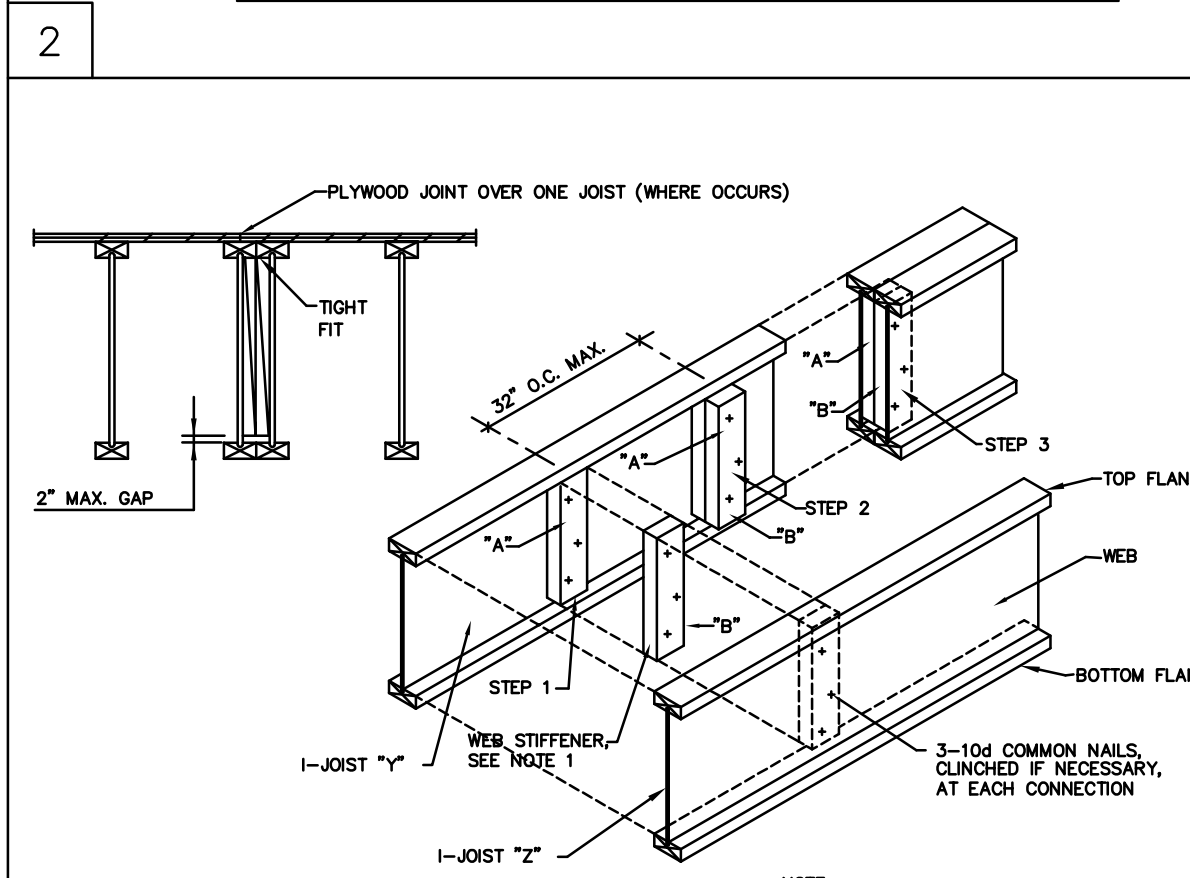

**ASSEMBLY SEQUENCE:**  
 STEP 1 - NAIL BLOCKS "A" TO FACE OF WEB ON JOIST. ONLY BACK WEB DURING NAILING TO PREVENT DAMAGE TO WEB/FLANGE CONNECTION.  
 STEP 2 - NAIL BLOCK "B" TO BLOCK "A".  
 STEP 3 - NAIL THRU WEB OF JOIST "Z" TO BLOCKS "A" AND "B". REPEAT STEPS 1 THRU 3 IF MORE THAN TWO JOISTS ARE TO BE JOINED.


**NOTE:**  
 1. WEB STIFFENERS FOR MULTI-JOIST JOIST ASSEMBLY WILL BE SUPPLIED BY MFR

**3** MULTI-JOIST ASSEMBLY

3

**TYPICAL I-JOIST PROJECT NOTES:**

- FOR NOTES, DETAILS, AND DIMENSIONS NOT ON THESE SHOP DRAWINGS, REFER TO PROJECT PLANS.
- SEE BILLS OF MATERIAL FOR ITEMS THAT WILL BE SUPPLIED.
- ALL CLOUDED NOTES, DIMENSIONS, ETC. REQUIRE VERIFICATION AND MUST BE MARKED EITHER "OK" OR THE CORRECT INFORMATION PROVIDED BY CUSTOMER, PRIOR TO RETURN TO MFR FOR FABRICATION.
- PLEASE BE AWARE THAT ANY CLOUDED ITEMS NOT ACKNOWLEDGED WILL REQUIRE CONTACT WITH RESPONSIBLE PARTIES AND MAY CAUSE DELAY IN THE PROCESSING OF YOUR ORDER.
- PLEASE VERIFY THAT ALL INFORMATION PROVIDED HEREWITH REFLECTS THE LATEST AVAILABLE PROJECT INFORMATION AND THAT ALL I-JOISTS LENGTHS CORRESPOND WITH ACTUAL FIELD DIMENSIONS PRIOR TO RETURN TO MFR FOR FABRICATION.
- ALL BRACING SHOWN IS INTEGRAL TO THE I-JOISTS FRAMING SYSTEM AND IS NOT TEMPORARY OR ERECTION BRACING. THE I-JOISTS WILL NOT SAFELY SUPPORT LOADS UNTIL FULLY BRACED, FULLY ATTACHED TO BEARING WALLS OR BEAMS, AND SHEATHING, BY OTHERS IS PROPERLY INSTALLED (SEE LAYOUTS AND DETAILS).
- INSTALLATION OF I-JOISTS MUST FOLLOW ANY ADDITIONAL REQUIREMENTS INDICATED ON THE LAYOUTS AND IN THE CALCULATIONS.
- ALL I-JOISTS ARE DESIGNED FOR UNIFORM LOADS AND CONCENTRATED LOADS NOTED ON THESE DRAWINGS AND CALCULATIONS. TEMPORARY CONSTRUCTION LOADS WHICH CAUSE STRESSES BEYOND DESIGN CRITERIA ARE NOT PERMITTED.
- ALL 2X, 4X, 6X ETC. FRAMING TO BE SUPPLIED BY OTHERS, UNO. (FMB0).
- METAL STRAPS AND/OR TIES USED FOR SEISMIC PURPOSES THAT ARE NAILED TO THE TOP OF THE TOP CHORD ARE TO USE 10d NAILING AT NO LESS THAN 3" OC IN A ROW. ACCEPTABLE STRAPS FOR TRUSS TOP CHORDS ARE LTL, LST, MST AND PAL. PLEASE CONTACT THE PROJECT MANAGER BELOW FOR ANY QUESTIONS AND/OR ISSUES WHERE NAILING INTO TOP CHORD IS A CONCERN.
- I-JOISTS ARE NOT DESIGNED TO SUPPORT ANY FIRE SPRINKLER AND/OR MECHANICAL LOADS OTHER THAN WHAT IS SHOWN ON THESE SHOP DRAWINGS, AND OR WHAT HAS BEEN PROVIDED IN THE DESIGN DEAD LOAD(S).
- THE PLACEMENT OF THE MECHANICAL UNITS AND SPRINKLER MAINS ARE TO BE AS NOTED ON THESE SHOP DRAWINGS. THE SUPPORTING TRUSSES HAVE BEEN SPECIFICALLY DESIGNED TO ACCOMMODATE THESE ITEMS. ALL COMPONENTS TRANSFERRING LOADS TO THE TRUSSES SHALL BE DESIGNED AND INSTALLED IN ACCORDANCE WITH THE DETAILS CONTAINED WITHIN THESE DRAWINGS. IF THE ACTUAL LOCATIONS DO NOT COINCIDE WITH THESE DRAWINGS CONTACT I-JOIST MFR.
- I-JOISTS DESIGNS ARE IN ACCORDANCE WITH THE CURRENT ADOPTED EDITION OF THE IBC, CBC, AND NATIONAL DESIGN SPECIFICATION.

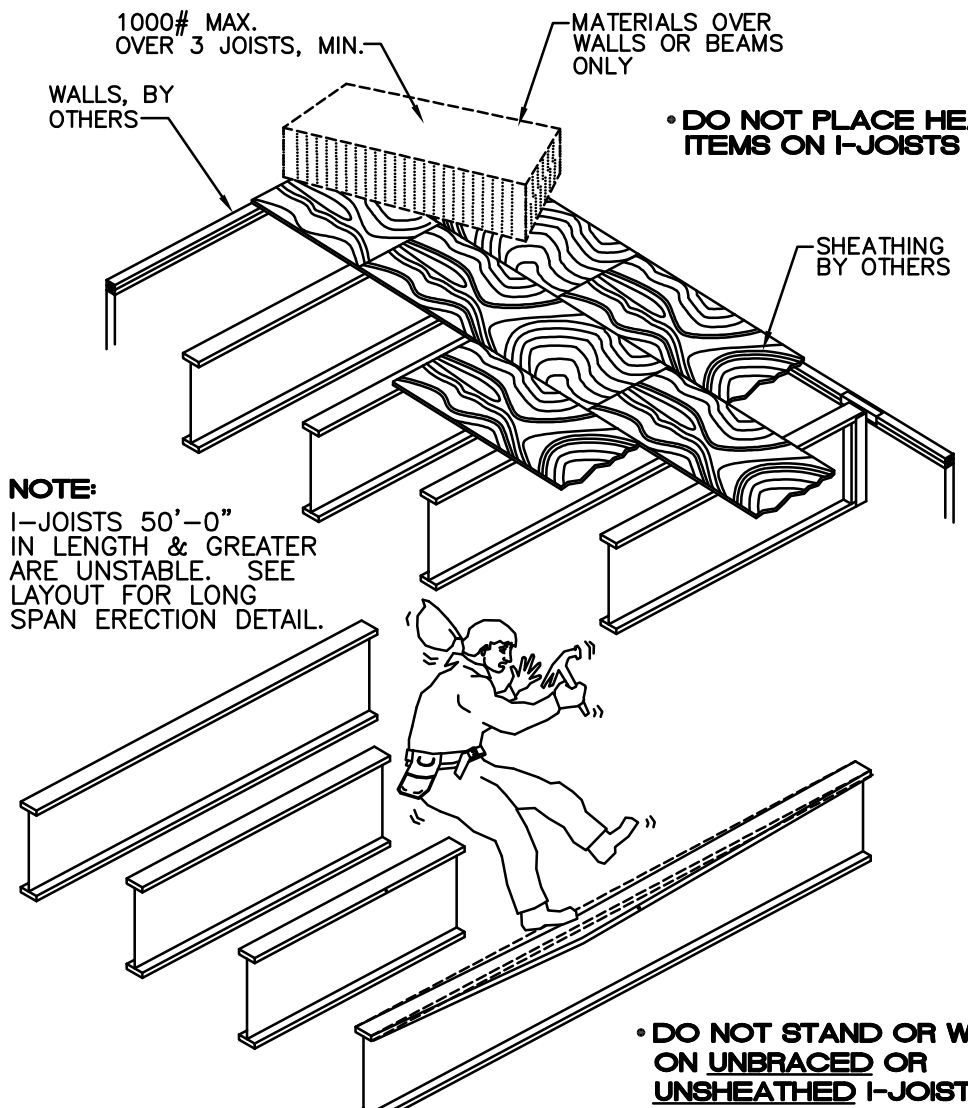

**INSTALLATION OF I-JOISTS**

**NOTE:**  
 I-JOISTS 50"-0" IN LENGTH & GREATER ARE UNSTABLE. SEE LAYOUT FOR LONG SPAN ERECTION DETAIL.

**DO NOT PLACE HEAVY ITEMS ON I-JOISTS**

**DO NOT STAND OR WALK ON UNBRACED OR UNSHEATHED I-JOISTS**

REVISED FOR CONSTRUCTION



ENGINEER  
 ASHLEY & VAUGHAN  
 805-547-2910  
 ARCHITECT  
 ARRIS STUDIO ARCHITECTS  
 805-547-2940  
 CUSTOMER  
 B/H CONSTRUCTION  
 805-462-3350

CALIFORNIA DEPARTMENT OF TRANSPORTATION  
 2885 SOUTH HIGUERA  
 SAN LUIS OBISPO, CALIFORNIA

G2T TRUSS LIST						
MARK	QTY	CLR SPAN	MFR LENGTH	DEPTH	HANGER (BLACK END)	HANGER (OTHER END)
2T01	37	30'-0 1/8"	29'-11 5/8"	27"	HTR418 H=18" HGRS	HTR418 H=18" HGRS
2T01D	3	30'-0 1/8"	29'-11 5/8"	27"	DBL RHU418-2 H=18" HGRS	RHU418-2 H=18" HGRS
2T02	8	18'-10 5/8"	18'-10 1/8"	27"	HTR418 H=18" HGRS	HTR418 H=18" HGRS
2T03	65	30'-11 3/4"	30'-11 1/4"	27"	HTR418 H=18" HGRS	HTR418 H=18" HGRS
2T03A	10	30'-11 3/4"	30'-11 1/4"	27"	HTR418 H=18" HGRS	HTR418 H=18" HGRS
2T03B	13	30'-11 3/4"	30'-11 1/4"	27"	HTR418 H=18" HGRS	HTR418 H=18" HGRS
2T04	8	19'-11 3/4"	19'-11 1/4"	27"	HTR418 H=18" HGRS	HTR418 H=18" HGRS
2T05	45	32'-3 3/4"	32'-3 1/4"	27"	HTR418 H=18" HGRS	HTR418 H=18" HGRS
2T05D	2	32'-3 3/4"	32'-3 1/4"	27"	DBL RHU418-2 H=18" HGRS	RHU418-2 H=18" HGRS
2T06	36	29'-4 3/8"	29'-3 7/8"	27"	HTR418 H=18" HGRS	HTR418 H=18" HGRS
2T06A	5	29'-1 7/8"	29'-1 3/8"	27"	HTR418 H=18" HGRS	HTR418 H=18" HGRS
2T07	5	24'-4 3/8"	24'-3 7/8"	27"	HTR418 H=18" HGRS	HTR418 H=18" HGRS
2T08	3	16'-11 7/8"	16'-11 3/8"	27"	HTR418 H=18" HGRS	HTR418 H=18" HGRS

KC METALS CONNECTORS ESR-2930						
QTY	MARK	DESCRIPTION	NAILING		REMARKS	
			HEADER	JOIST		
494	2H01	HTR418	10-16d	4-10d x 1 1/2	(TRUSS HGRS)	
110	2H02	TR3516	6-10d	2-10d x 1 1/2	(I-JOIST HGRS)	
4	2H03	H3516-2	26-10d x 1 1/2	12-10d x 1 1/2	(I-JOIST HGRS)	
10	2H04	RHU418-2	8-16d	6-10d x 1 1/2	(TRUSS HGRS)	
6	2H05	RA418 TF OFFSET R	2-16d	2-10d x 1 1/2	(TRUSS HGRS)	
6	2H06	RA418 TF OFFSET L	2-16d	2-10d x 1 1/2	(TRUSS HGRS)	

DESIGN LOADS		
	FLOOR	PSF
LIVE LOAD	50	PSF
PART LOAD	15	PSF
DEAD LOAD	25	PSF
TOTAL LOAD	90	PSF


DESIGN DEFLECTION:  
 $\Delta_{LL} \leq L/480$   $\Delta_{TL} \leq L/360$   
 LOAD DURATION FACTOR = 1.00  
 TRUSS BTM CHORDS SHALL BE DESIGNED TO RESIST A MIN CEILING LL OF 10 PSF

ROSEBURG FOREST PRODUCTS I-JOIST ESR-1251				
QTY	MARK	DESCRIPTION	LENGTH	
6	2J01	16" RFPI 70	11'-0"	FABE 2WS1
15	2J02	16" RFPI 70	5'-0"	FABE 2WS1
63	2J03	16" RFPI 70	23'-0"	FABE 2WS1

FABE=field attach both ends

WEB STIFFENERS			
QTY	MARK	DESCRIPTION	LENGTH
500	2WS1	PLY 7/8 x 3 1/2	12"

FLOOR FRAMING PLAN

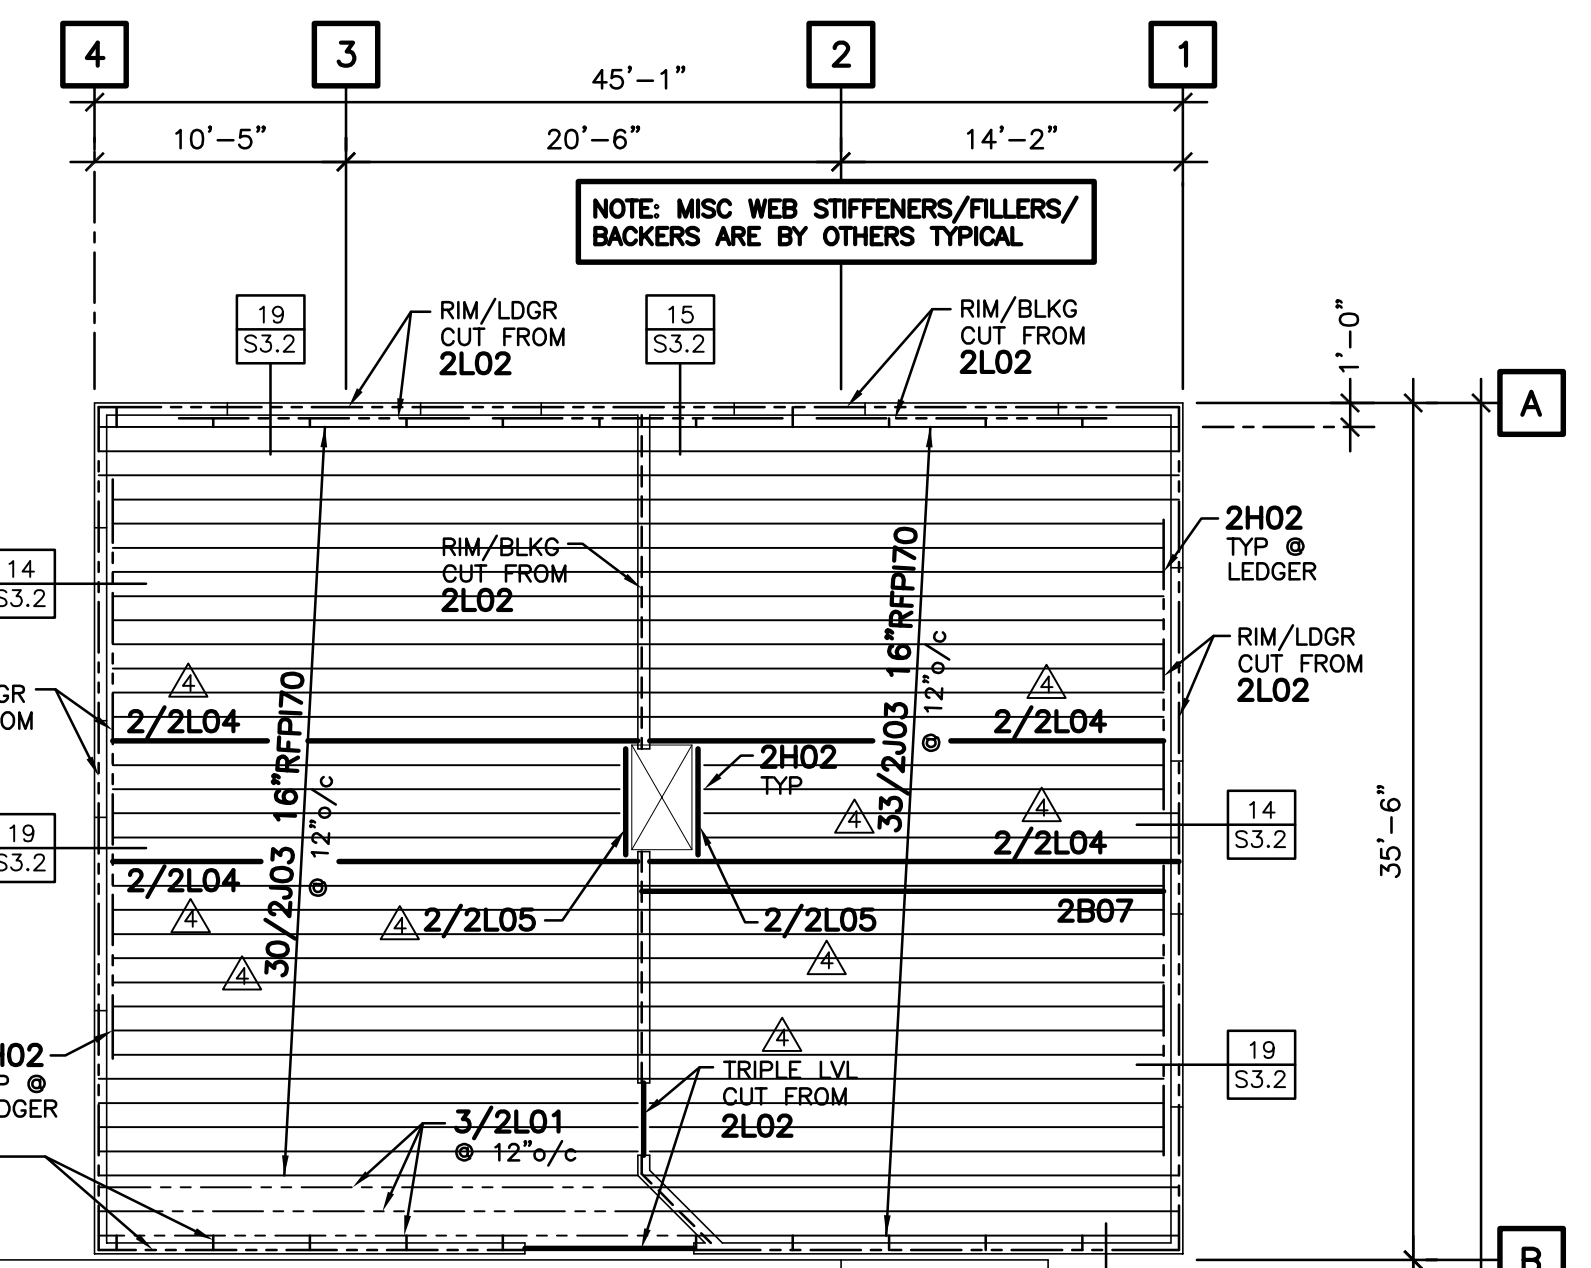

MISC. MATERIAL LIST			
ITEM	QTY		USE
1/2"x5/8" LSL B/C BRACING	1070 LF	STD	G2T B/C BRACING (SEE DETAIL)
27" TRUSS BLOCKING (1'-8 1/4" LENGTH)	24		BTM CHORD BRG BLKG


24F-V8 INDUSTRIAL APPEARANCE 14% MOISTURE CONTENT					
QTY	MARK	WIDTH	DEPTH	LENGTH	CAMBER
8	2B01	12 1/4"	24"	30'-0"	STD
4	2B02	12 1/4"	24"	41'-0"	STD

RC=5' LC=5'

24F-V4 INDUSTRIAL APPEARANCE 14% MOISTURE CONTENT					
QTY	MARK	WIDTH	DEPTH	LENGTH	CAMBER
1	2B03	12 1/4"	24"	17'-0"	STD

ROSEBURG FOREST PRODUCTS 2.0 LVL ESR-1210					
QTY	MARK	WIDTH	DEPTH	LENGTH	
1	2B06	5 1/2"	16"	10'-0"	
1	2B07	3 1/2"	16"	23'-0"	
3	2L01	1 3/4"	16"	27'-0"	
1	2L02	1 3/4"	16"	350'-0"	
26	2L03	1 3/4"	18"	11'-0"	
8	2L04	1 3/4"	16"	23'-0"	
4	2L05	1 3/4"	16"	6'-0"	

(FIELD CUT RIM/BLKG LEDGER/BEAMS) (24'-0" MIN LENGTHS)

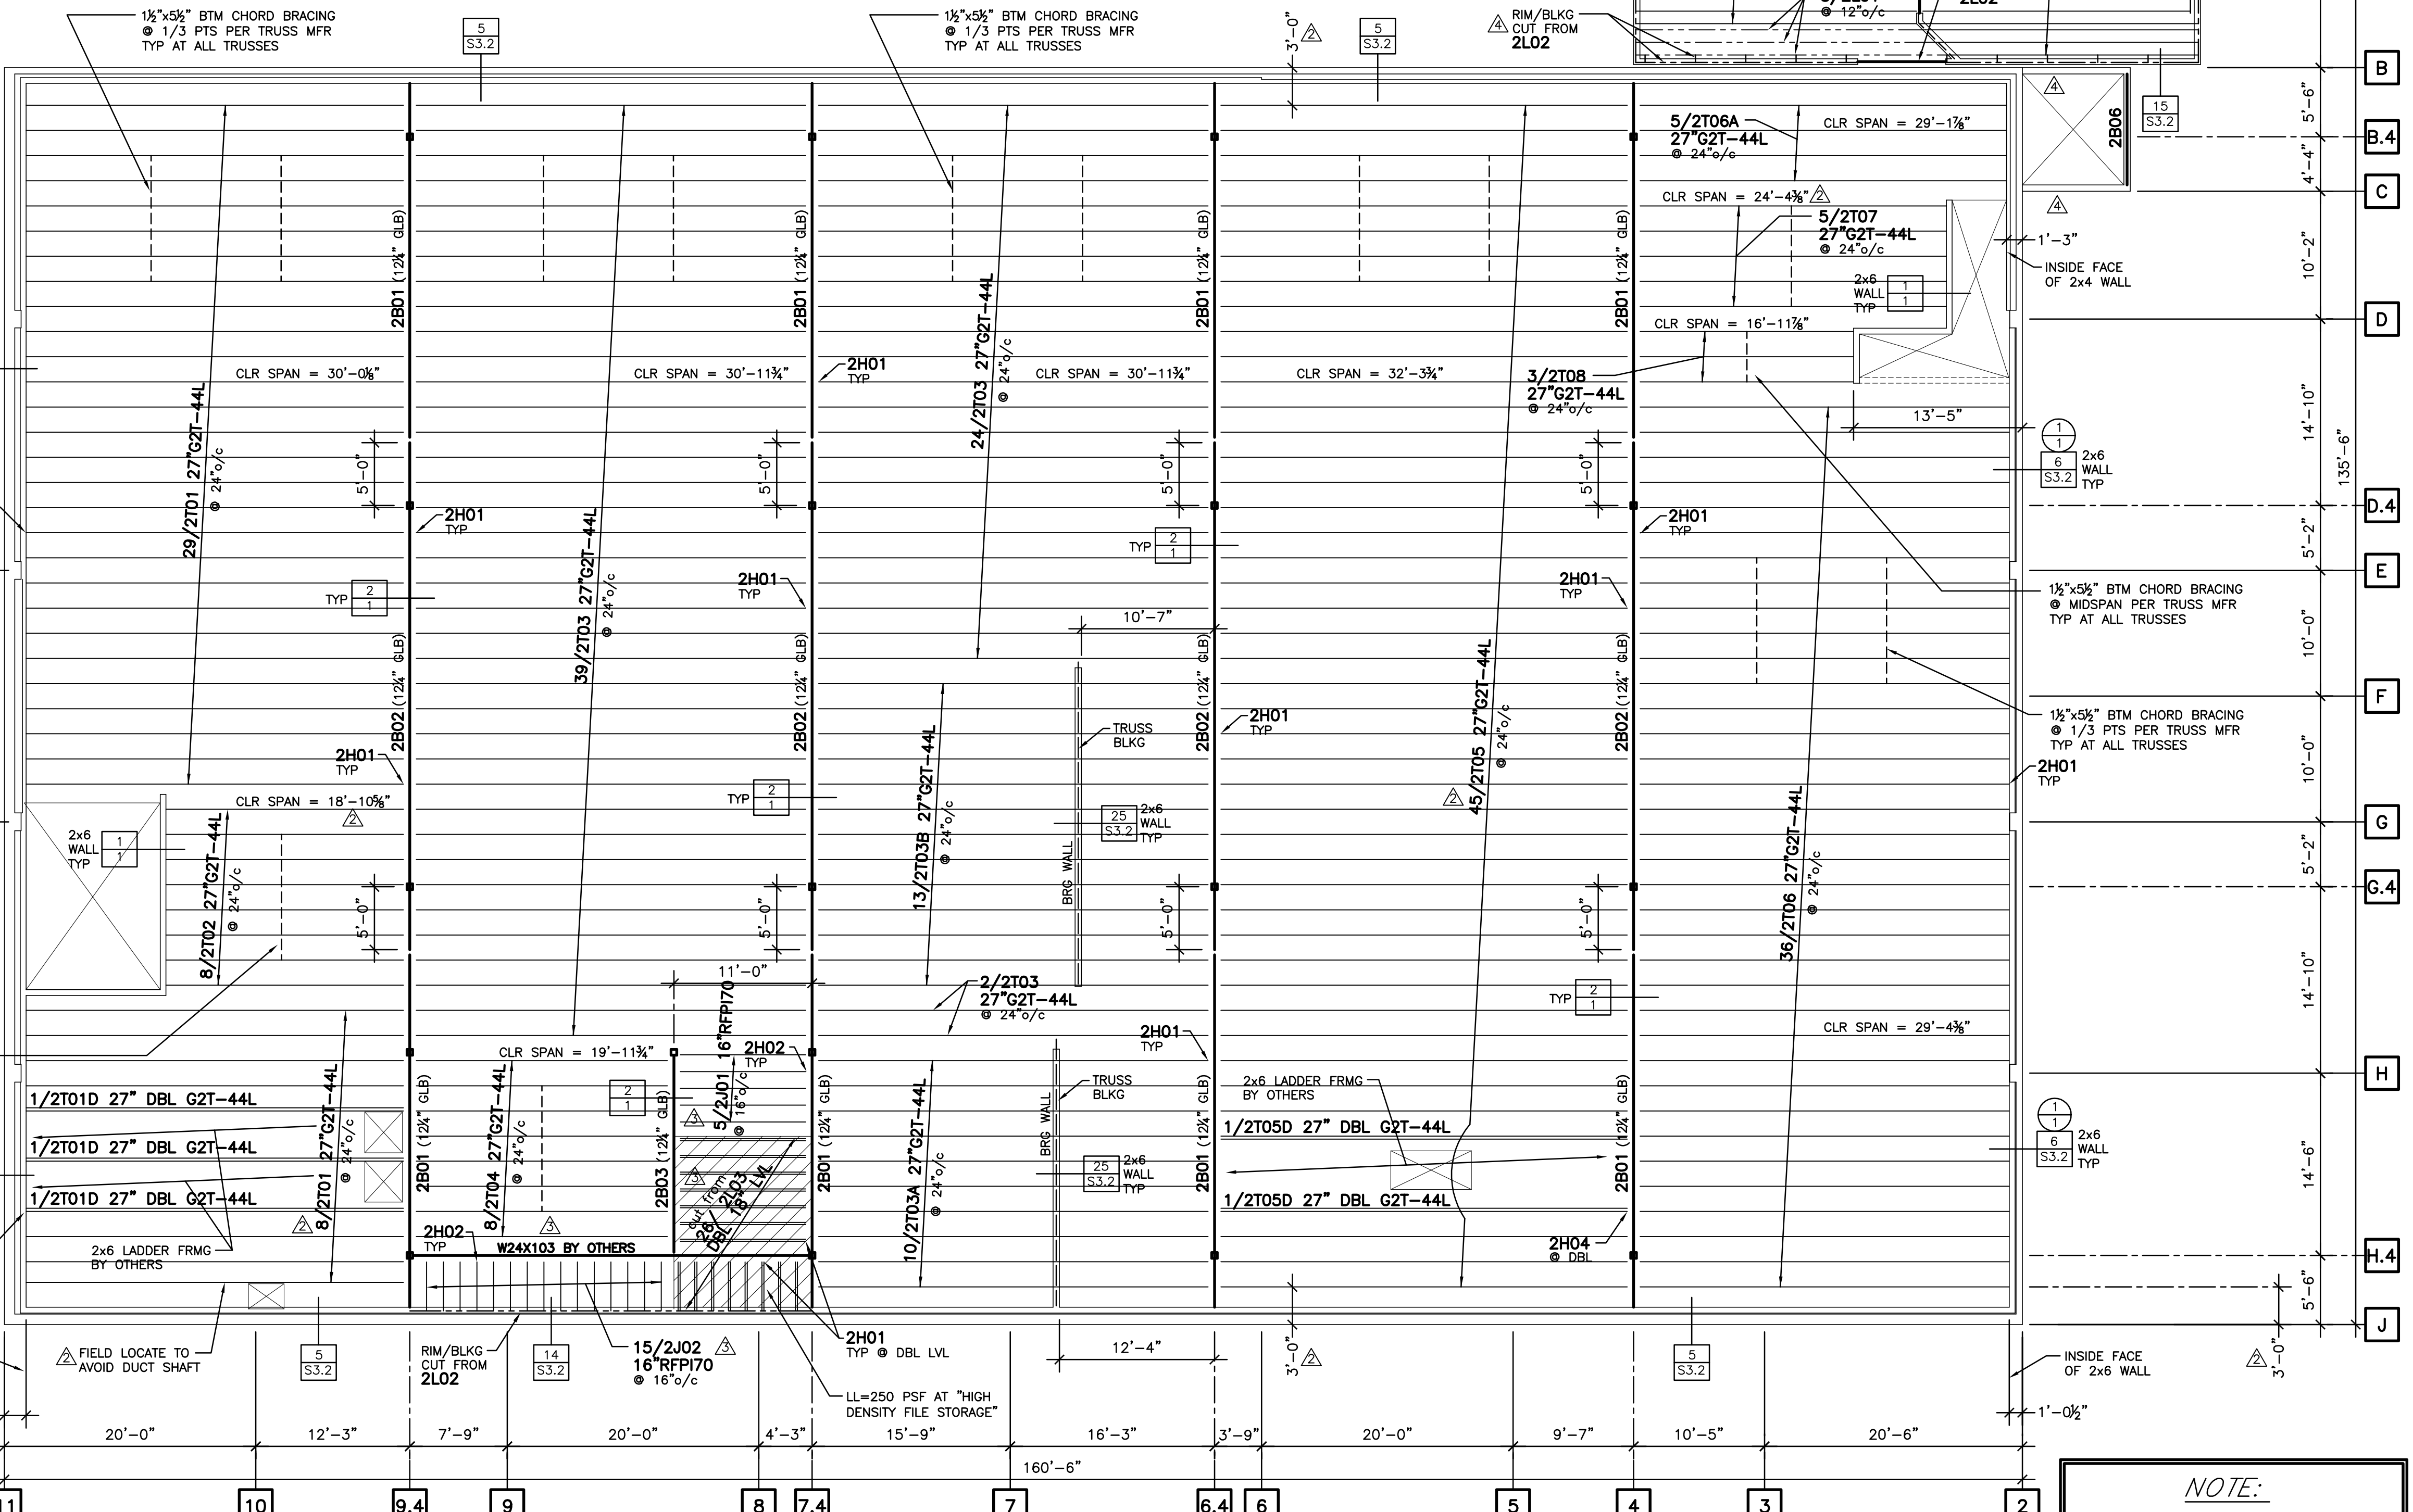

**WARNING:**  
 Drilling, sawing, sanding or machining wood products generates wood dust and other substances known to the State of California to cause cancer. Avoid inhaling dust generated from wood products or use a dust mask or other safeguards for personal protection.  
 Wood products emit chemicals known to the State of California to cause birth defects or other reproductive harm.

NOTE: SHOP MARKED BLACK END OF TRUSS TOWARDS THIS GRID

NOTE: REFERENCE MANUFACTURERS PRODUCT GUIDE FOR PRODUCT INSTALLATION AND ADDITIONAL INFORMATION.

REVISIONS

DATE: 10/14/15

1 - 12/07/15 PER REVISION AND RESUBMIT

2 - 12/22/15 PER TRUSS MARKUPS

3 - 1/25/16 PER STORAGE RFI

4 - 3/07/16 PER REVISED ANNEX DWGS

ENGINEER: ASHLEY & VAUGHAN ENGINEERING, INC. 805-547-9210

ARCHITECT: ARRIS STUDIO ARCHITECTS 805-547-2240

CUSTOMER: G2 NATIONAL U.S. 2155 GREEN VISTA DRIVE # 212 SPARKS, NEVADA 89431. 805-462-3350


**G2 NATIONAL**  
 Evolution in Wood-Framed Structure.<sup>®</sup>

REVISED FOR CONSTRUCTION

CALIFORNIA DEPARTMENT OF TRANSPORTATION  
 2885 SOUTH HIGUERA  
 SAN LUIS OBISPO, CALIFORNIA

SHEET 3 OF 4

REFERENCE SEPARATE ROOF TRUSS SUBMITTAL FOR ACTUAL TRUSS LAYOUT

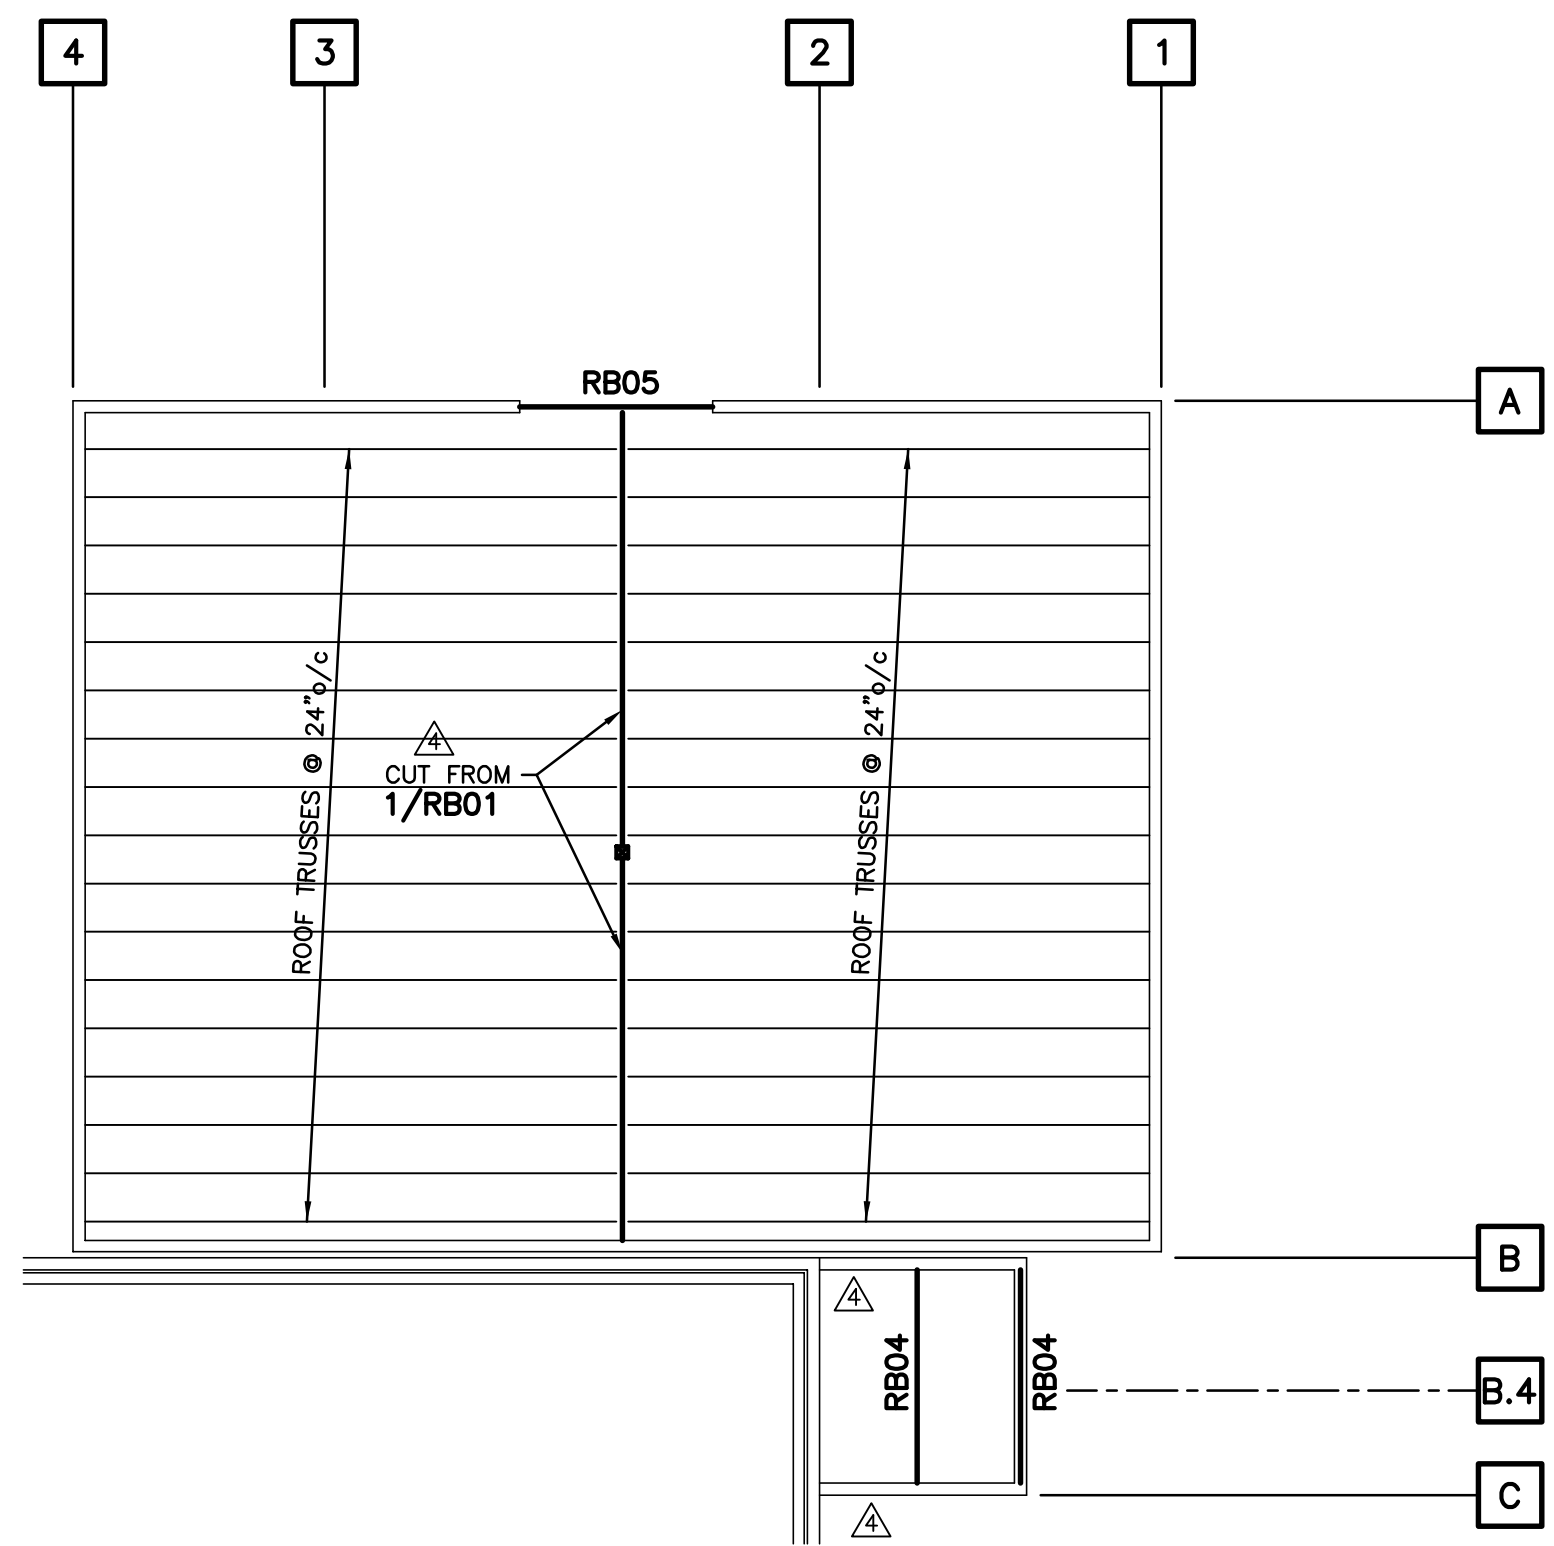

PARTIAL ROOF FRAMING PLAN


(REF: S-2.3)  
SCALE: 1/8" = 1'-0"

24F-V4 INDUSTRIAL FRAMING APPEARANCE 14% MOISTURE CONTENT					
QTY	MARK	WIDTH	DEPTH	LENGTH	CAMBER
1	RB01	3 1/2	18	36'-6"	STD

ROSEBURG FOREST PRODUCTS 2.0 LVL ESR-1210				
QTY	MARK	WIDTH	DEPTH	LENGTH
2	RB04	5 1/2	16	10'-0"
1	RB05	3 1/2	11 7/8	9'-0"

**WARNING:**  
Drilling, sawing, sanding or machining wood products generates wood dust and other substances known to the State of California to cause cancer. Avoid inhaling dust generated from wood products or use a dust mask or other safeguards for personal protection.  
Wood products emit chemicals known to the State of California to cause birth defects or other reproductive harm.

NOTE: MISC WEB STIFFENERS/FILLERS/BACKERS ARE BY OTHERS TYPICAL

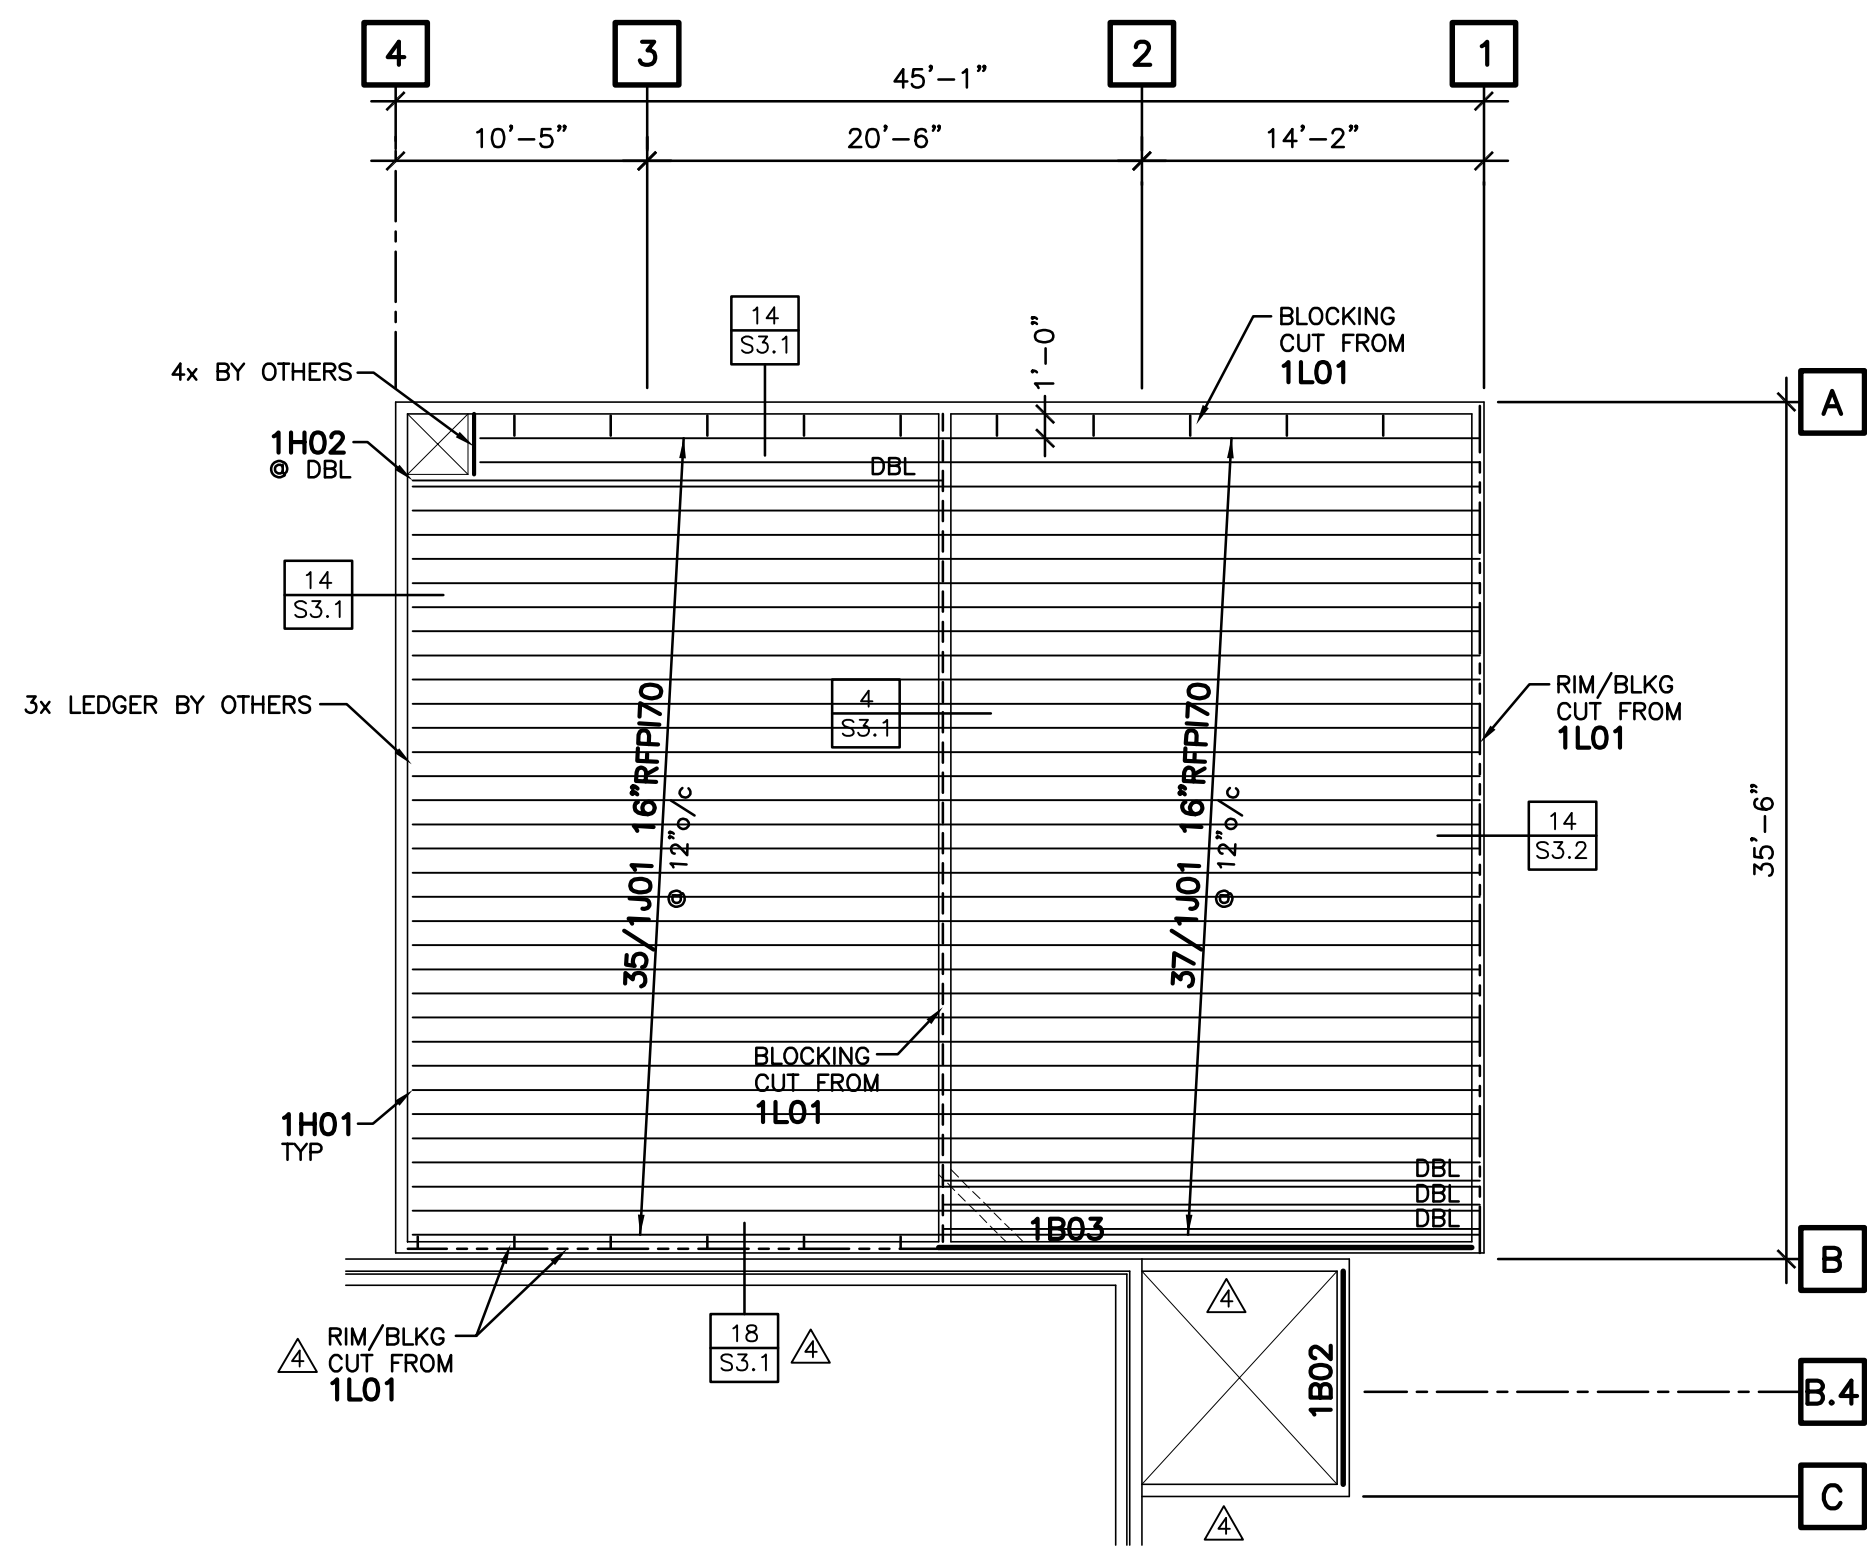

FOUNDATION FRAMING PLAN

(REF: S-2.1)  
SCALE: 1/8" = 1'-0"

ROSEBURG FOREST PRODUCTS 1-JOIST ESR-1251			
QTY	MARK	DESCRIPTION	LENGTH
72	1J01	16" RFPI 70	23'-0"

FABE=field attach both ends

WEB STIFFENERS			
QTY	MARK	DESCRIPTION	LENGTH
360	1WS1	PLY 7/8 x 3 1/2	12"

KC METALS CONNECTORS ESR-2930					
QTY	MARK	DESCRIPTION	NAILING		REMARKS
			HEADER	JOIST	
33	1H01	TR3516	6-10d	2-10d x 1 1/2	SINGLE
1	1H02	RAI3516-2	2-16d	2-10d x 1 1/2	SINGLE

ROSEBURG FOREST PRODUCTS 2.0 LVL ESR-1210				
QTY	MARK	WIDTH	DEPTH	LENGTH
1	1B02	5 1/2	16	10'-0"
1	1B03	3 1/2	16	23'-0"
1	1L01	1 3/4	16	120'-0"

(FIELD CUT RIM/BLKG) (24'-0" MIN LENGTHS)

DESIGN LOADS		
	FLOOR	
LIVE LOAD	50	PSF
PART LOAD	15	PSF
DEAD LOAD	25	PSF
TOTAL LOAD	90	PSF

DESIGN DEFLECTION:  
 $\Delta_{LL} \leq L/480$     $\Delta_{TL} \leq L/360$   
 LOAD DURATION FACTOR = 1.00

REVISED FOR CONSTRUCTION



CALIFORNIA DEPARTMENT OF TRANSPORTATION  
2885 SOUTH HIGUERA  
SAN LUIS OBISPO, CALIFORNIA

ENGINEER: ASHLEY & VANCE ENGINEERING, INC.  
805-547-9010  
ARCHITECT: ARRIS STUDIO ARCHITECTS  
805-547-2940  
CUSTOMER: B/H CONSTRUCTION  
805-462-3350

DATE: 10/14/15  
REVISIONS:  
1 - 12/07/15 PER REVISE AND RESUBMIT  
2 - 12/22/15 PER TRUSS MARKUPS  
3 - 1/25/16 PER STORAGE RFI  
4 - 3/07/16 PER REVISED ANNEX DWGS

NOTE:  
REFERENCE MANUFACTURERS PRODUCT GUIDE FOR PRODUCT INSTALLATION AND ADDITIONAL INFORMATION.